
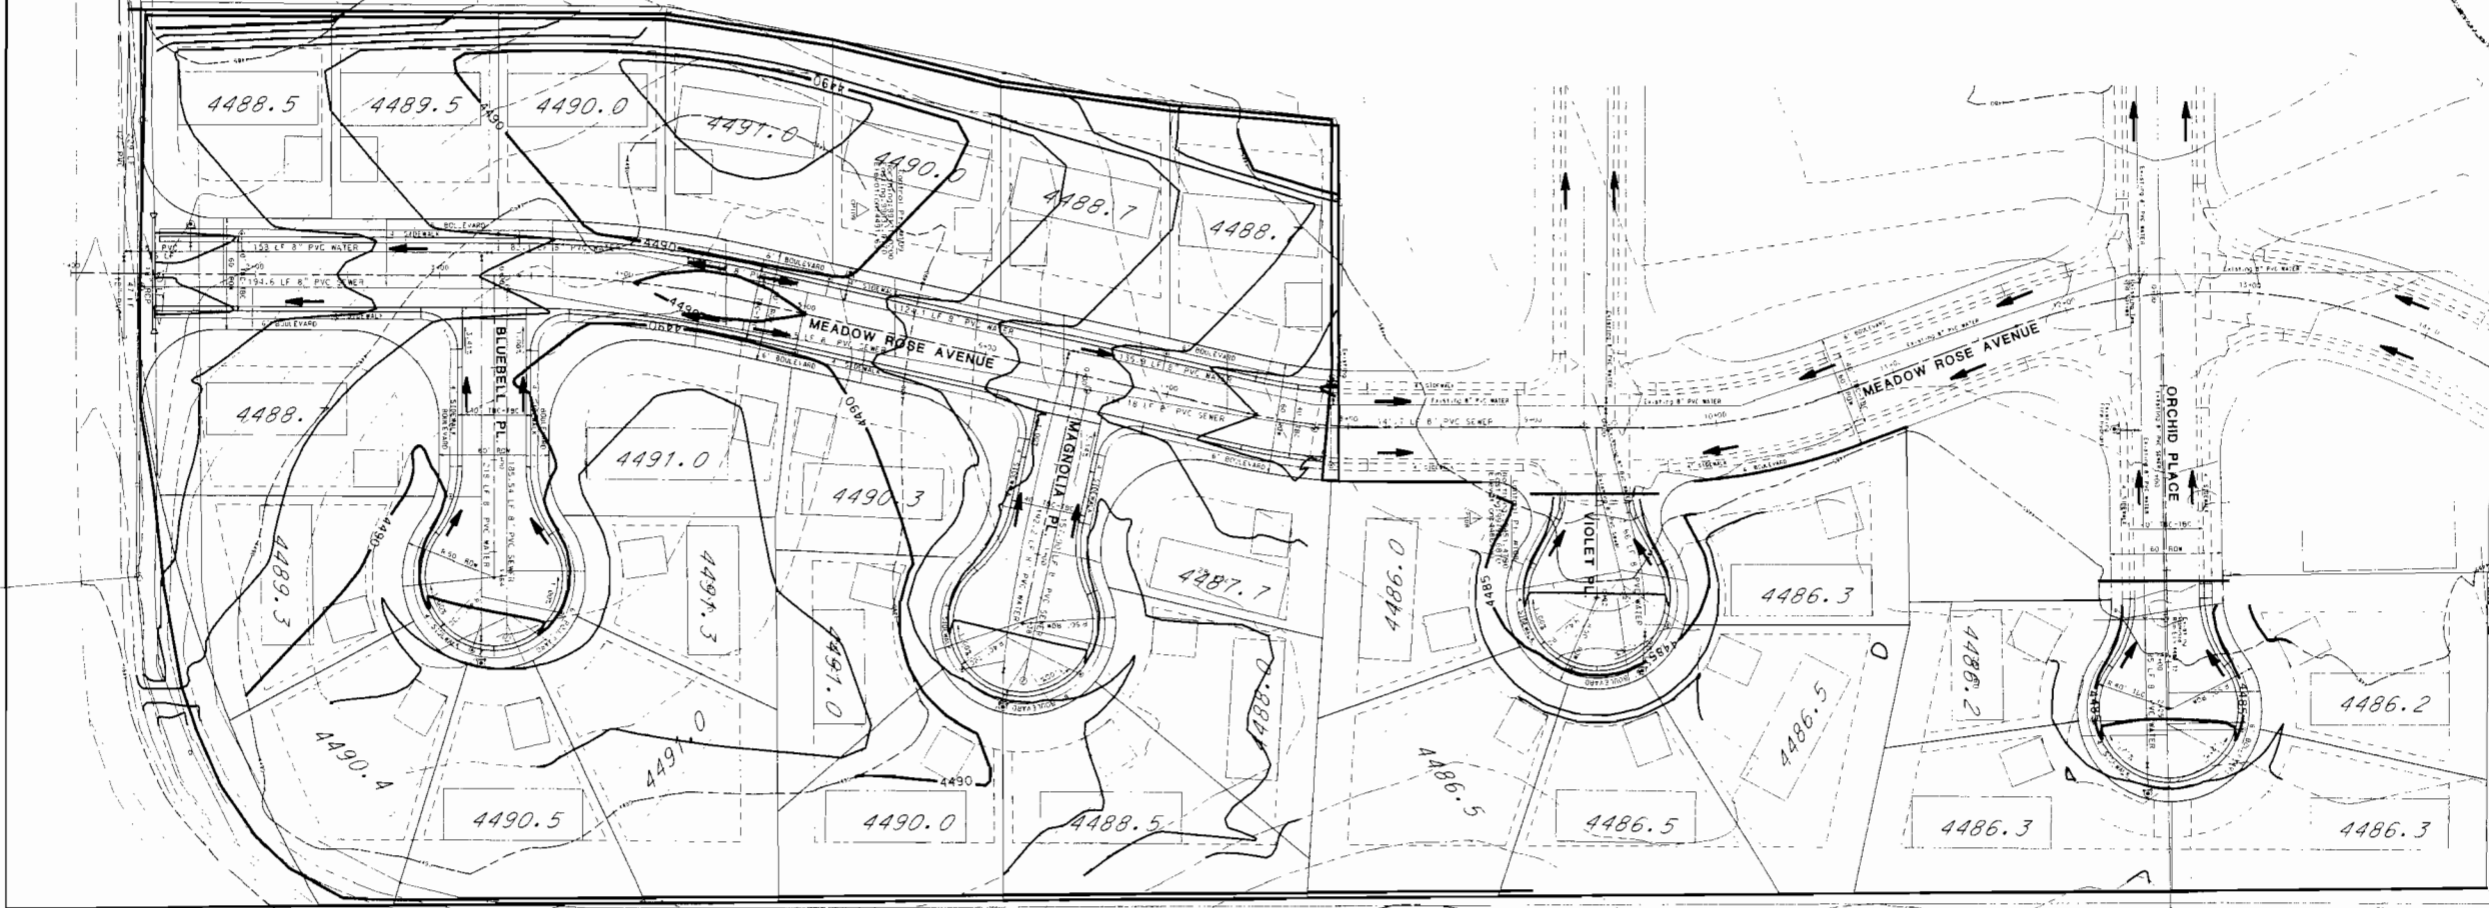


DATE PLOTTED: 9/29/06
 PLOT SCALE: 1"=50'

———— SILT FENCE
 → DRAINAGE FLOW
 4490.0
 RECOMMENDED TOP OF FOUNDATION ELEVATIONS
 SHOWN AT PROPOSED LOCATION FOR EACH TRAILER.

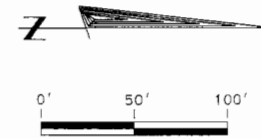

RECORD DRAWING
 SEPTEMBER 29, 2006

SURVEY:	NJS ENGR.	DESIGN:	JP
DATE:	6/05	DATE:	1/06
DRAW:	CDK	CHECK:	
DATE:	4/7/06	DATE:	

NJS ENGINEERING
 P.O. BOX 226
 123 E. JACKSON BLVD. SUITE 1
 SPEARFISH, SD 57783
 TELEPHONE: (605) 642-4772
 FAX: (605) 642-4773

REV.#	DESCRIPTION	DATE	CHKD
1	RECORD DRAWING	9/29/06	JP

SHEET TITLE:	GRADING PLAN
PROJECT:	PRAIRIE BLOSSOM MANUFACTURED HOUSING COMMUNITY PHASE IV GILLETTE, WYOMING

SHEET 23 OF 35
Preliminary Grading Plan.dgn
PROJECT NO: 3923