



DESIGNER: KAL/GWB PROJ. MGR. MFL

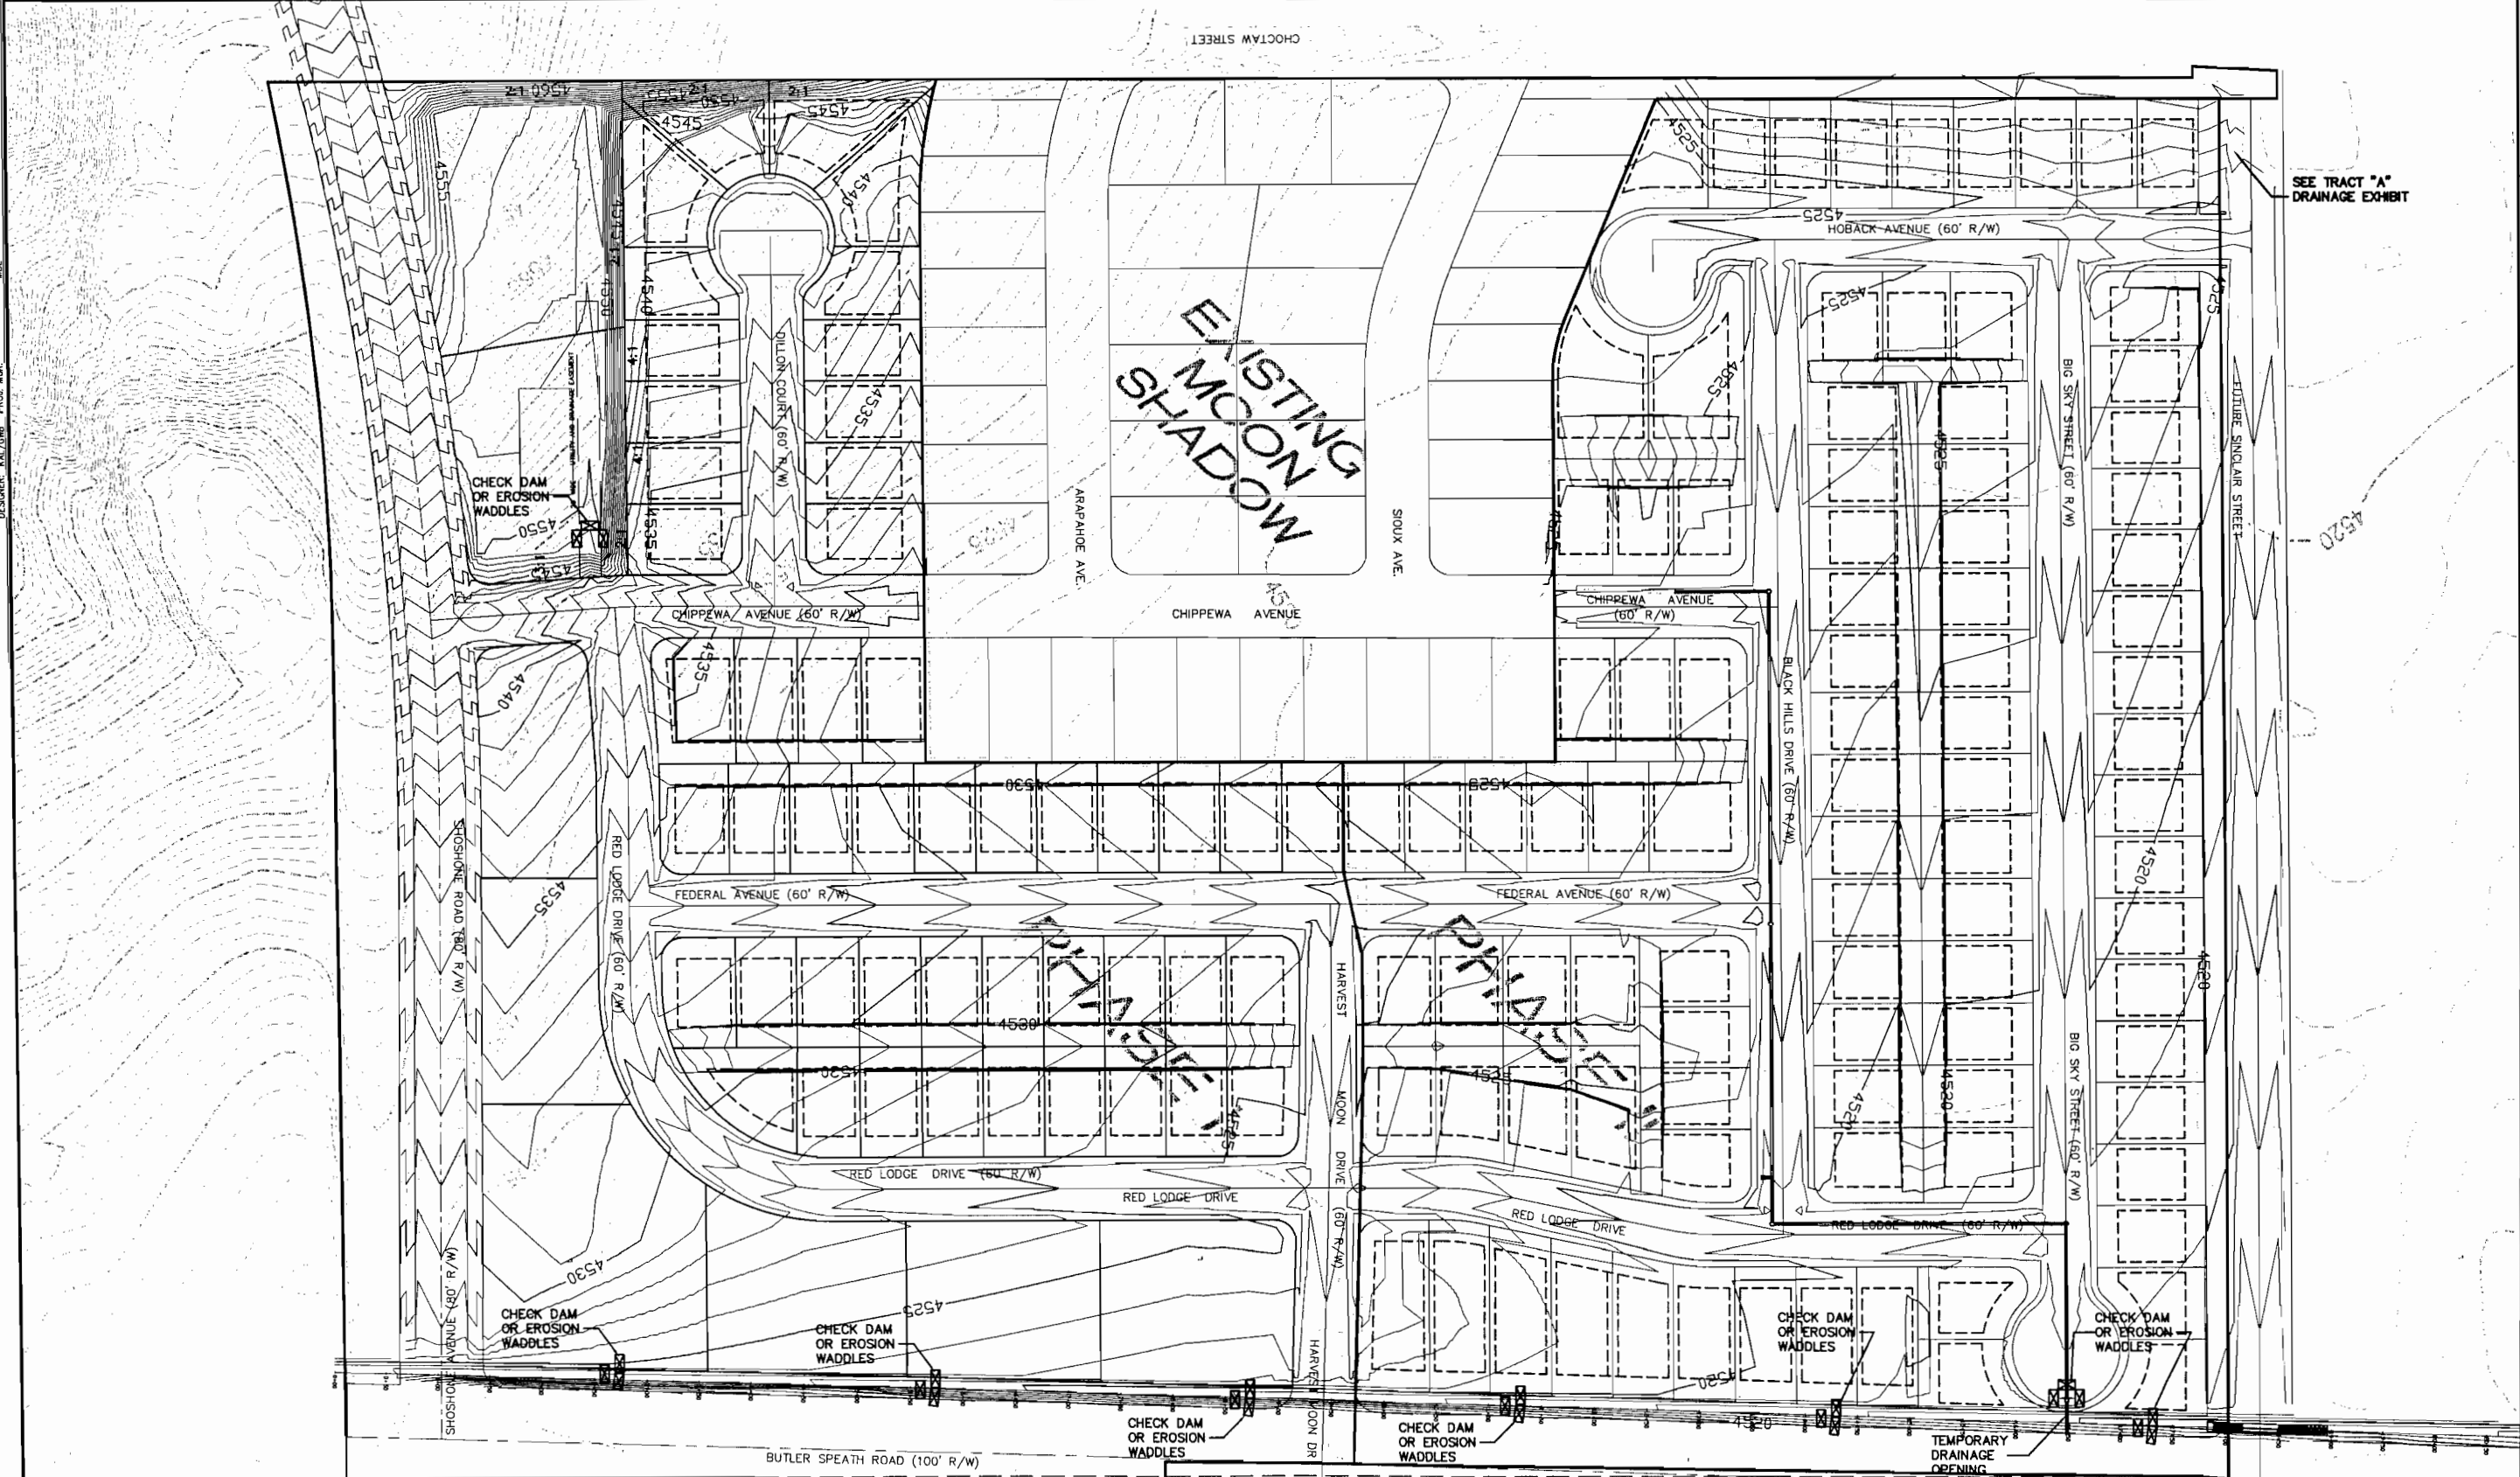

EXISTING MOON SHADOW

SEE TRACT "A" DRAINAGE EXHIBIT

- NOTES:
1. ALL SLOPES 3:1 AND GREATER WILL RECEIVE EROSION CONTROL BLANKETS
  2. CHECK DAMS OR WADDLES SHALL BE PLACED IN ALL DRAINAGEWAYS SPACED 300' O.C.

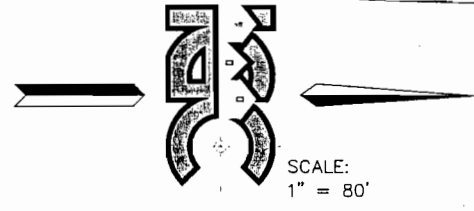

NO.	DATE	DESCRIPTION (LOCATION)
1	8-4-06	GWB REVISED GRADING COOT. CT.
2	8-17-06	GWB REVISED GRADING COOT. CT.
3	10-27-06	GB/AL SHOW EROSION CT. PER CITY
4	12-08-06	KL INTERIM RECORD DRAWINGS
5	11-19-07	JOB FINAL RECORD DRAWINGS

NOTE: The engineer preparing these plans will not be responsible for, or liable for, unauthorized changes to or uses of these plans. All changes to the plans must be in writing and must be approved by the preparer of these plans.

**MOON SHADOW FILING 2**  
**ROUGH GRADING**  
**EROSION CONTROL PLAN**

CLIENT: GILLETTE LAND DEVELOPMENT DATE SUBMITTED: 10-27-2006


IGC MANAGEMENT INC.  
 1807 Capitol Avenue  
 Cheyenne, WY 82001  
 Office: 307.636.5773  
 Fax: 307.636.7227



SHEET NUMBER  
**RG1**  
 OF 4 SHEETS  
 SCALE  
 VERTICAL: 1" = 10'  
 HORIZONTAL: 1" = 80'  
 JOB NUMBER  
**G105-0005**

PLOT DATE/TIME: Nov 19, 2007 - 1:35pm DRAWING PATH: N:\GCC\G005\2\0\Revised Drawings\  
 PLOTTED BY: Ebsener DRAWING NAME: GP-FG1.dwg  
 DESIGNER: KL/AB PROJ. MGR:  
 PLOTTING VENDOR: Layout

XREF: prefin-PRMA  
 XREF: CP-101B  
 XREF: PRTOFC

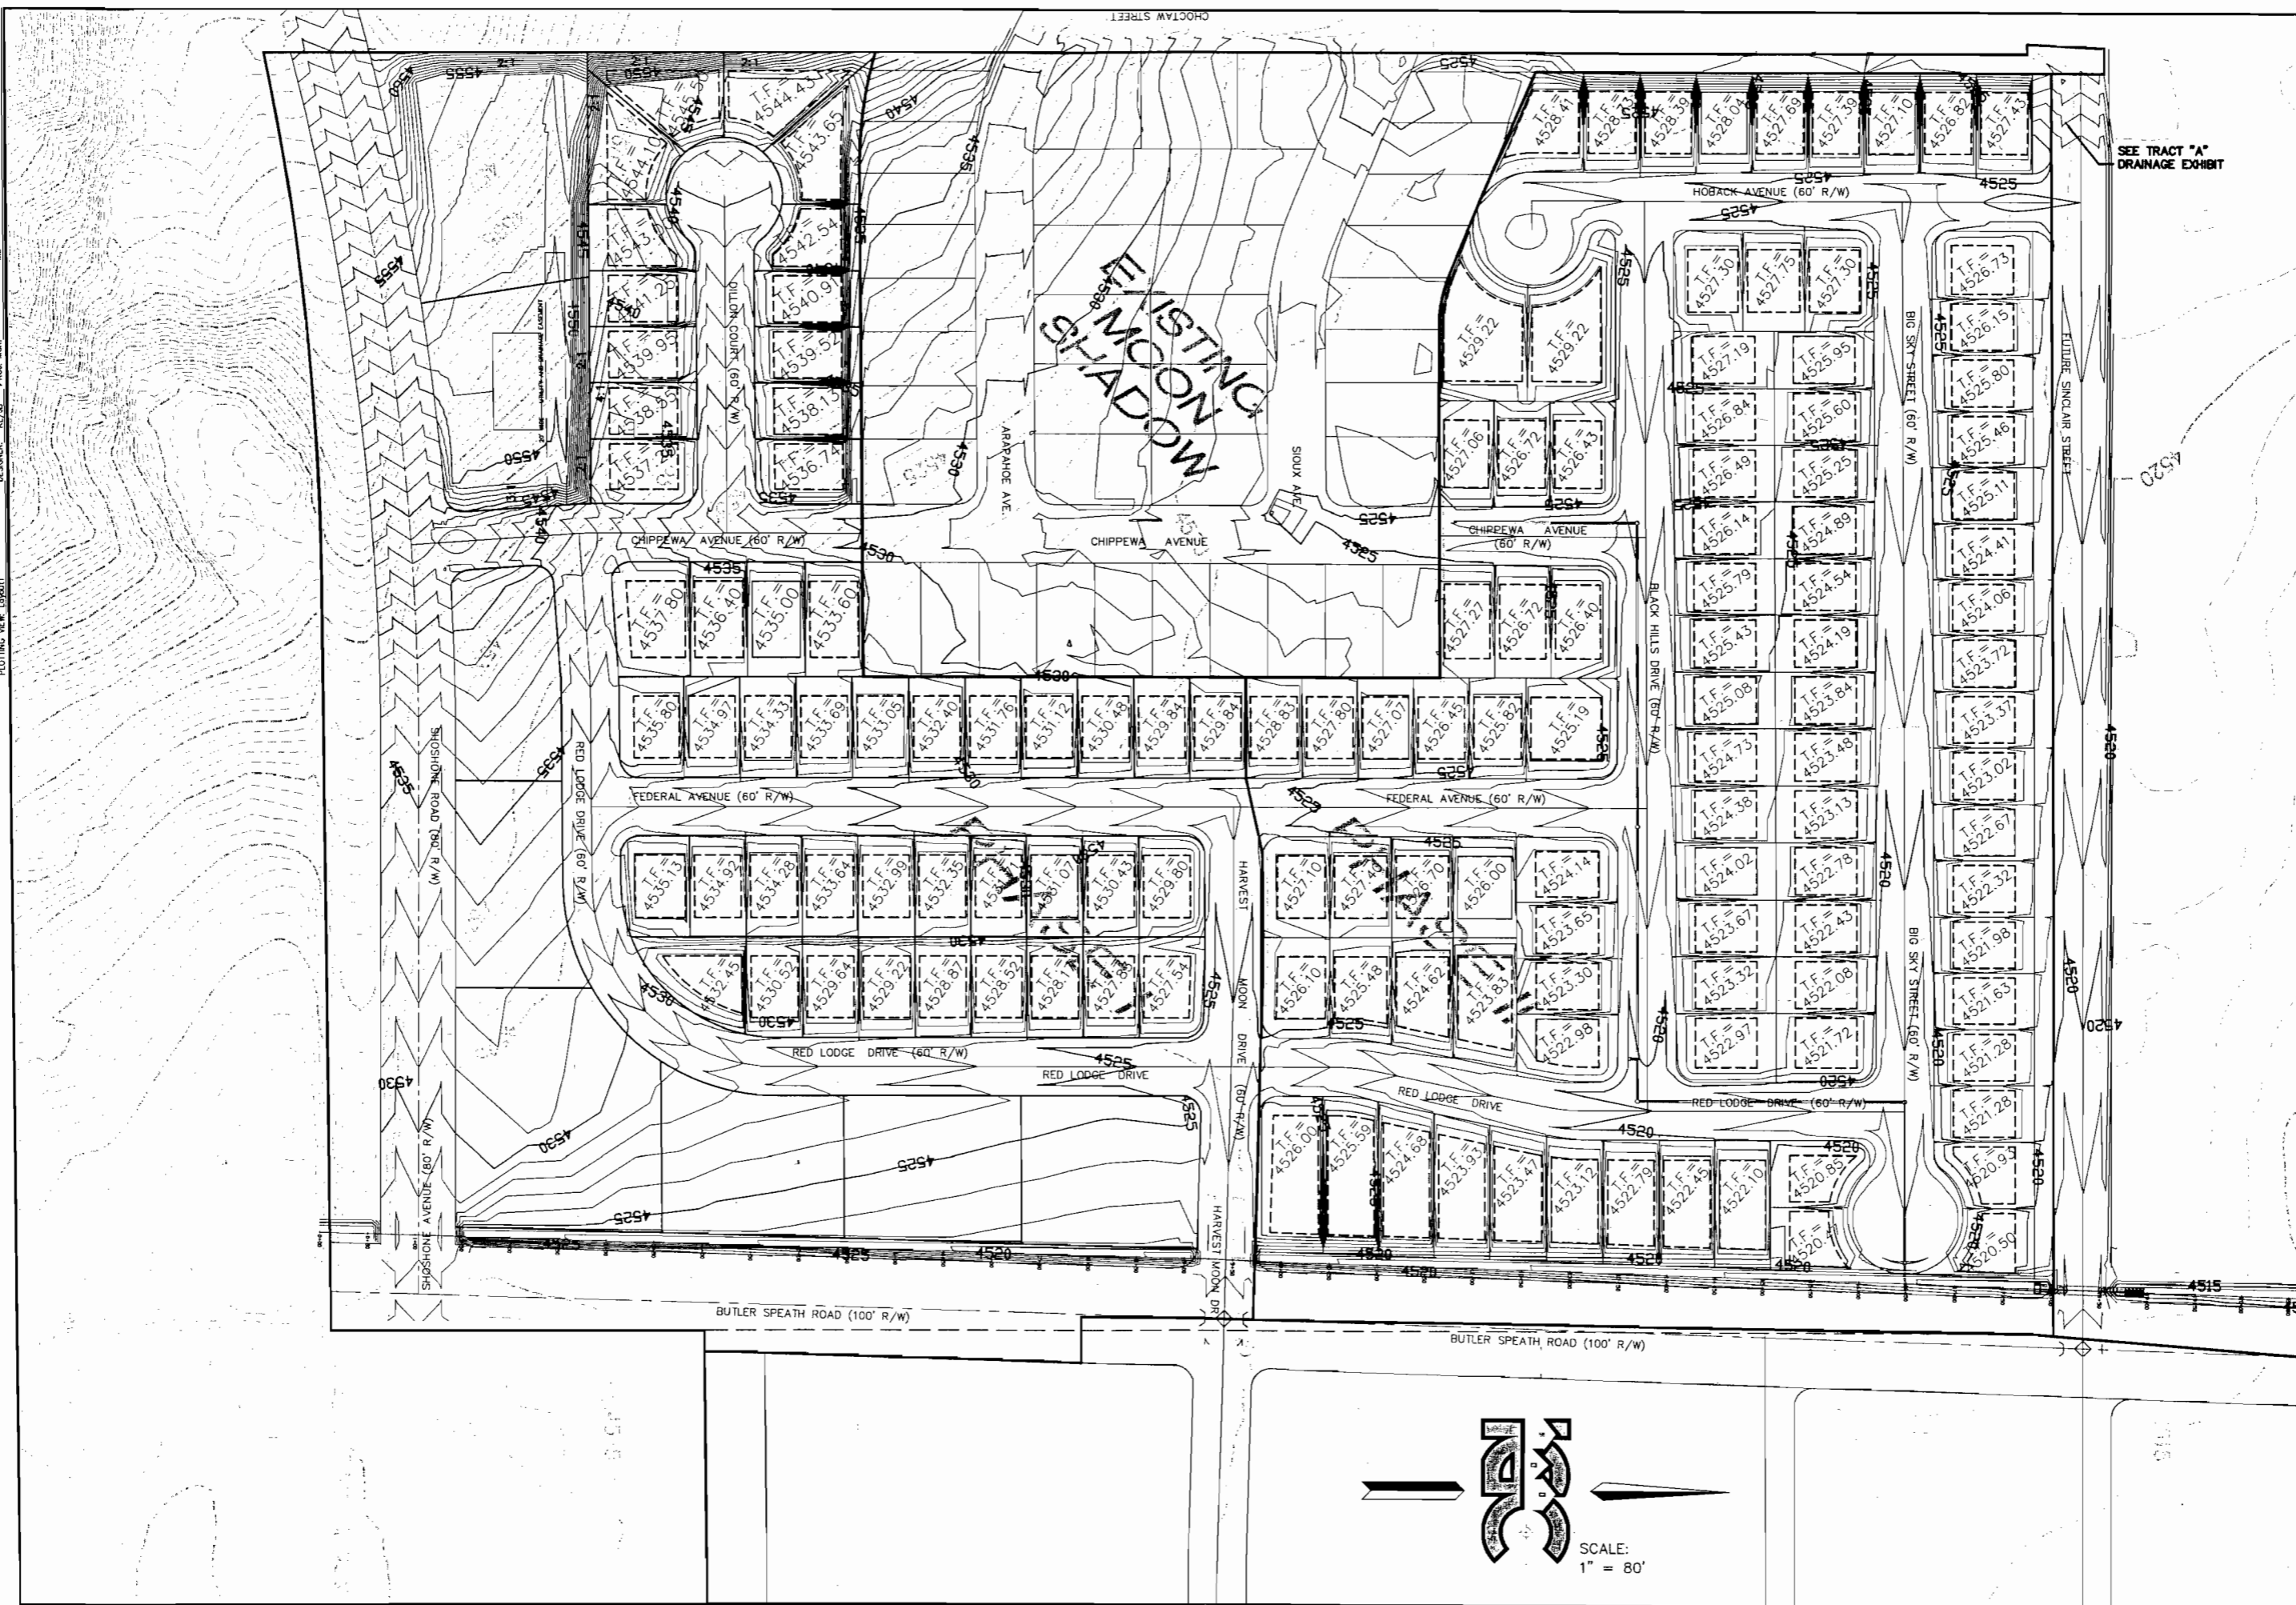

SEE TRACT "A"  
DRAINAGE EXHIBIT


NO.	DATE	INT.	REVISION (DESCR.)
1	08-27-06	MB/AB	ADD TO PLANS FOR CITY COMMENTS
2	10-27-06	CMB	REGRADE TRACT A
3	12-08-06	KL	PER CITY OF GILLETTE
4	11-19-07	JSB	INTERIM RECORD DRAWINGS
			FINAL RECORD DRAWINGS

NOT: The engineer preparing these plans will not be responsible for, or liable for, unauthorized changes to or uses of these plans. Any such changes or uses of the plans must be in writing and must be approved by the preparer of these plans.

**MOON SHADOW FILING 2**  
**FINISH GRADING PLAN**

CLIENT: GILLETTE LAND DEVELOPMENT DATE SUBMITTED: 10-27-2006

IGC MANAGEMENT INC.  
 1807 Capitol Avenue  
 Cheyenne, WY 82001  
 Office: 307.636.6773  
 Fax: 307.636.7227

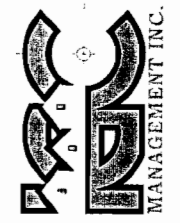

SHEET NUMBER  
**Fg1**  
 OF 1 SHEETS  
 SCALE:  
 VERTICAL: 1" = N/A  
 HORIZONTAL: 1" = 80'  
 JOB NUMBER  
**G105-0005**