



DESIGNER: KAL/OWB - PROJ. MGR.

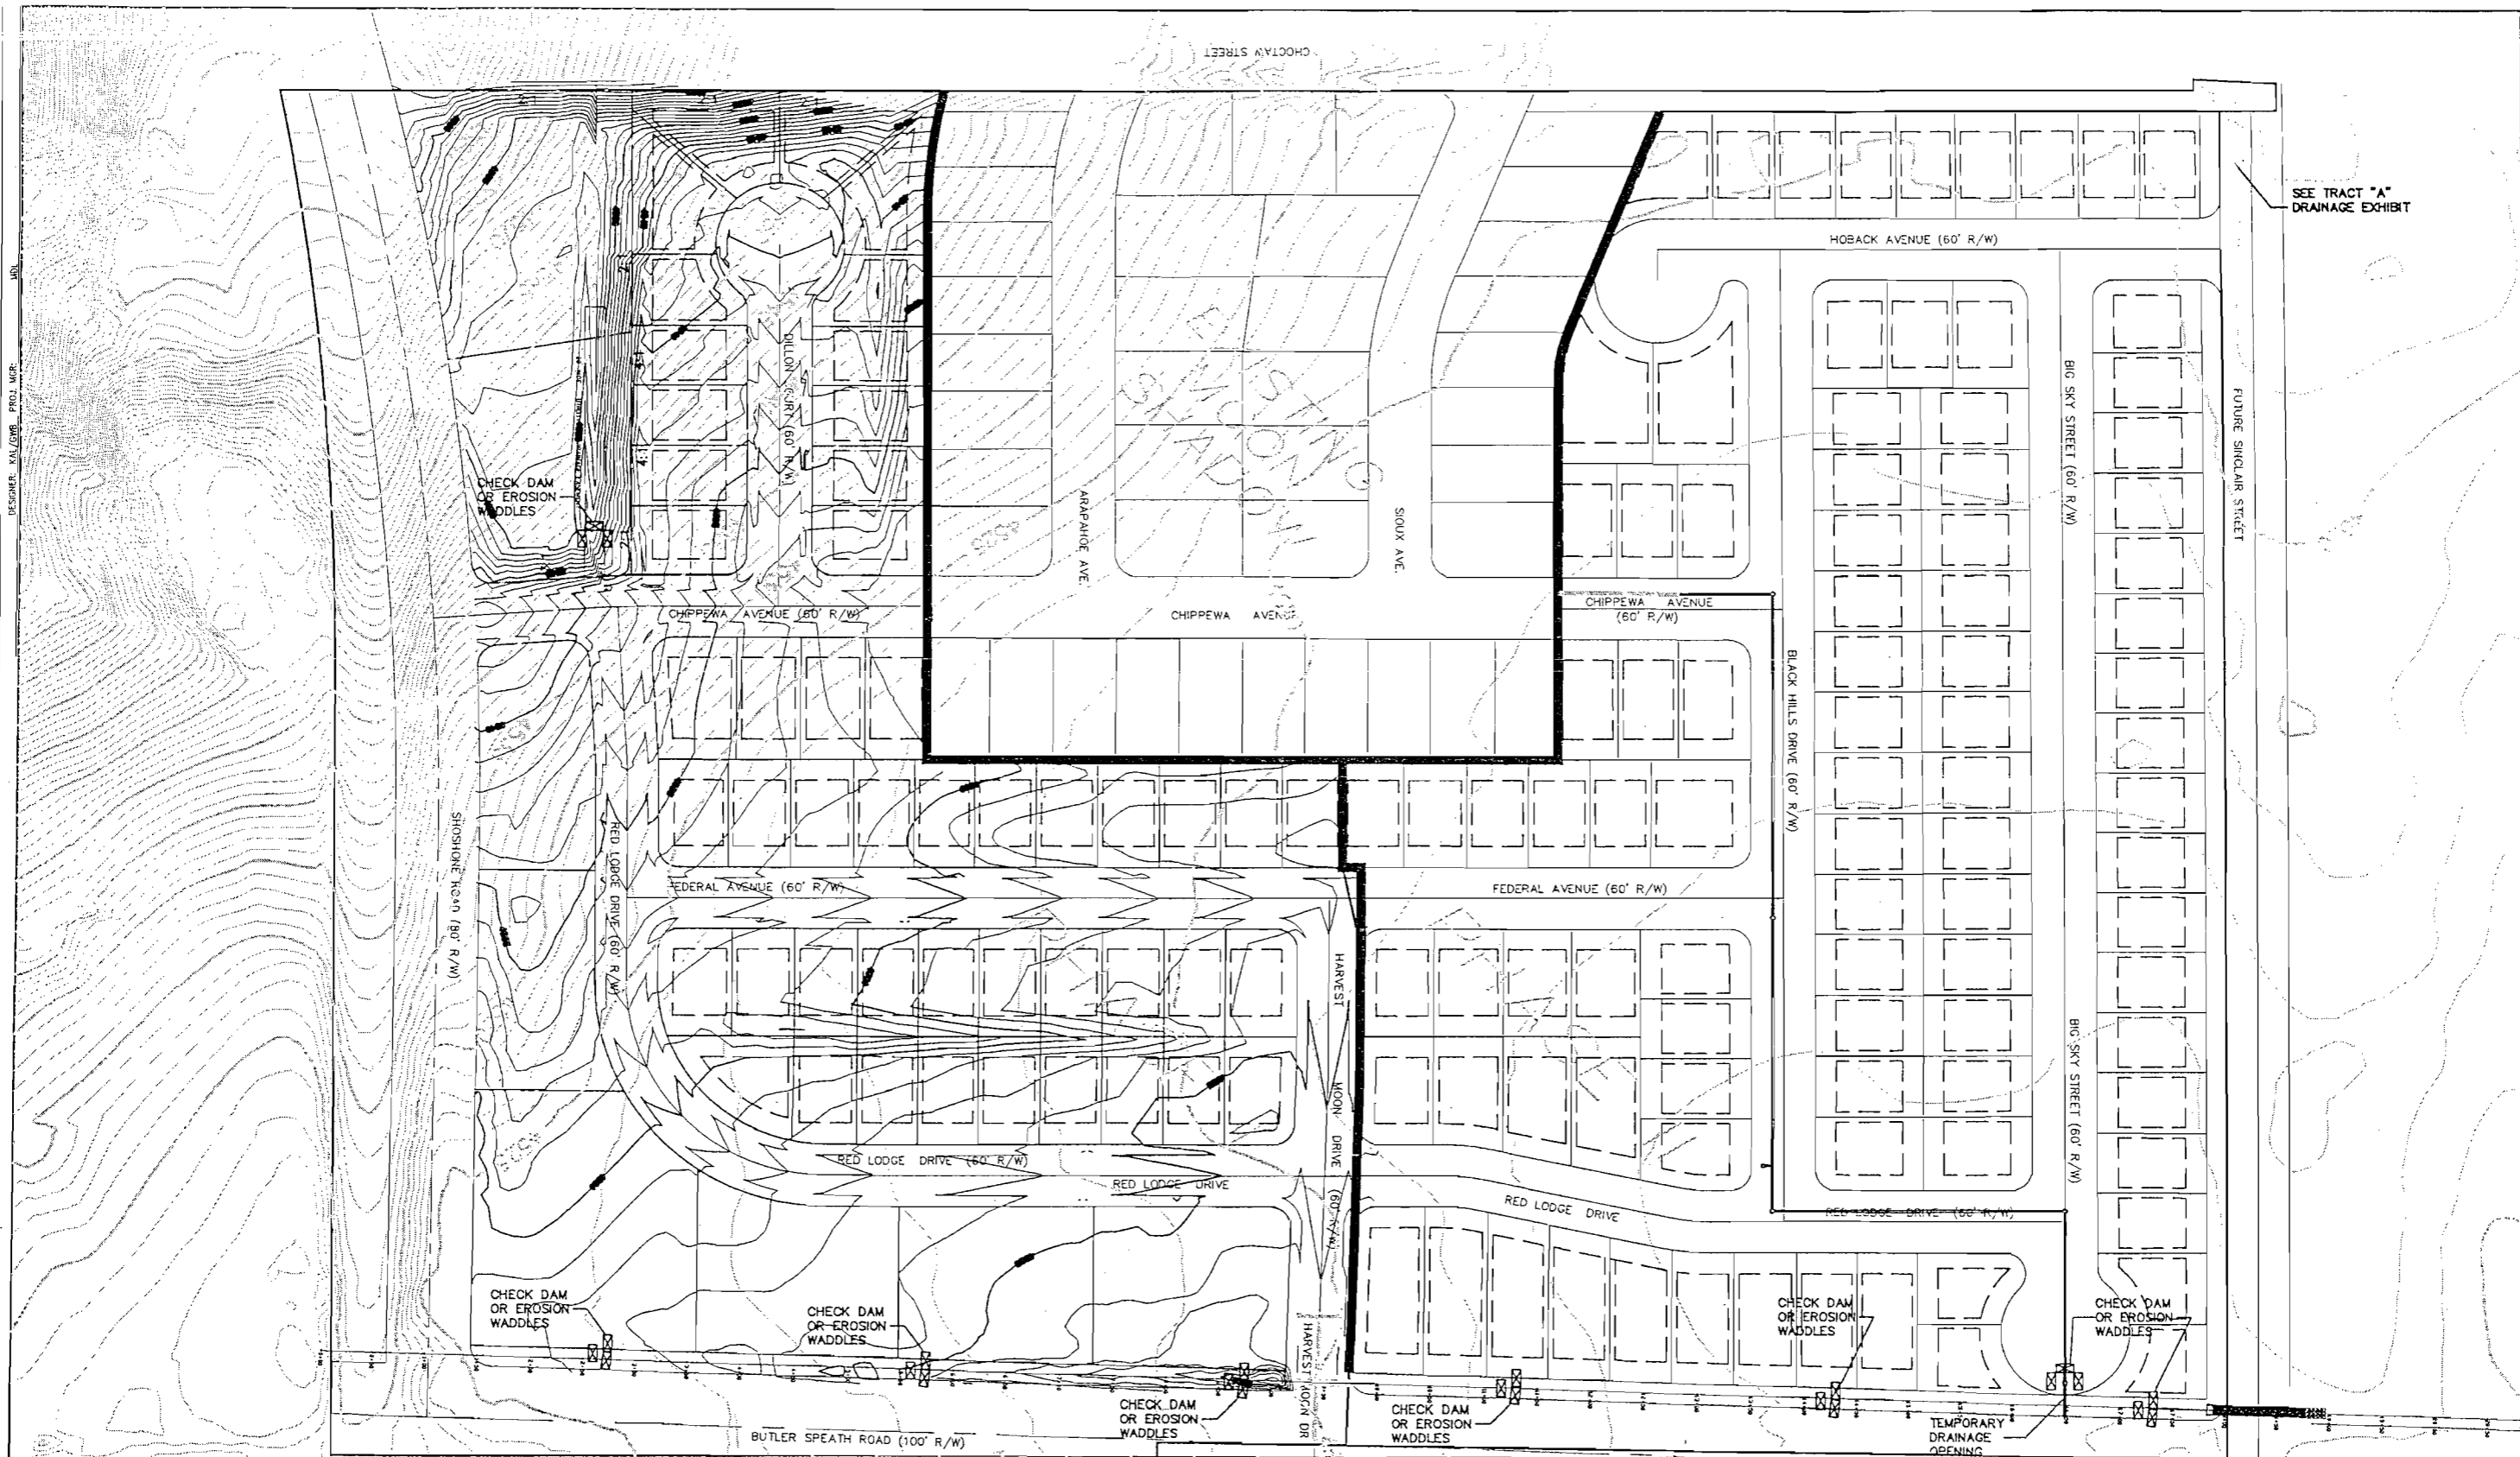

- NOTES:
1. ALL SLOPES 3:1 AND GREATER WILL RECEIVE EROSION CONTROL BLANKETS
  2. CHECK DAMS OR WADDLES SHALL BE PLACED IN ALL DRAINAGEWAYS SPACED 300' O.C.

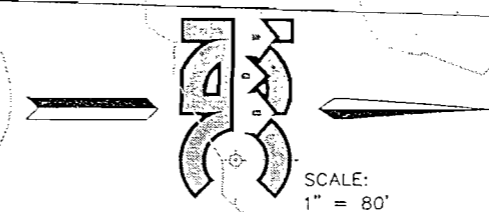

SEE TRACT "A" DRAINAGE EXHIBIT


NO.	DATE	BY	REVISION (DESCRIBE)
1	08-17-06	CMB	ISSUED FOR CITY
2	10-27-06	GG/AL	REVISED GRADING
3	10-27-06	GG/AL	REMOVED GRADING
4	12-08-06	KL	FOR CITY REVIEW
5	07-31-07	CMB	FINAL RECORD DRAWINGS

NOTE: The engineer preparing these plans will not be responsible for or liable for unauthorized changes to or uses of these plans. All changes to the plans must be in writing and must be approved by the preparer of these plans.

MOON SHADOW FILING 2  
 PHASE 1 ROUGH GRADING  
 EROSION CONTROL PLAN


CLIENT: GILLETTE LAND DEVELOPMENT DATE SUBMITTED: 10-27-2006

IGC MANAGEMENT INC.  
 1807 Capitol Avenue  
 Cheyenne, WY 82001  
 Office: 307.635.5773  
 Fax: 307.635.7227

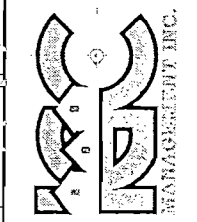


SHEET NUMBER  
 RG1  
 OF 4 SHEETS  
 SCALE  
 VERTICAL: 1" = XX  
 HORIZONTAL: 1" = XX  
 JOB NUMBER  
 G105-0005

PLOT DATE/TIME: JUL 23, 2007 - 10:32am DRAWING PATH: P:\WORKING\GILLETTE\0505-0005\ENGINEERING\WY\05-0005.PHT  
 PLOTTING BY: JLR  
 DESIGNED BY: JLR  
 CHECKED BY: JLR  
 PROJECT NO: 0505-0005  
 DRAWING NAME: CP-FG-005

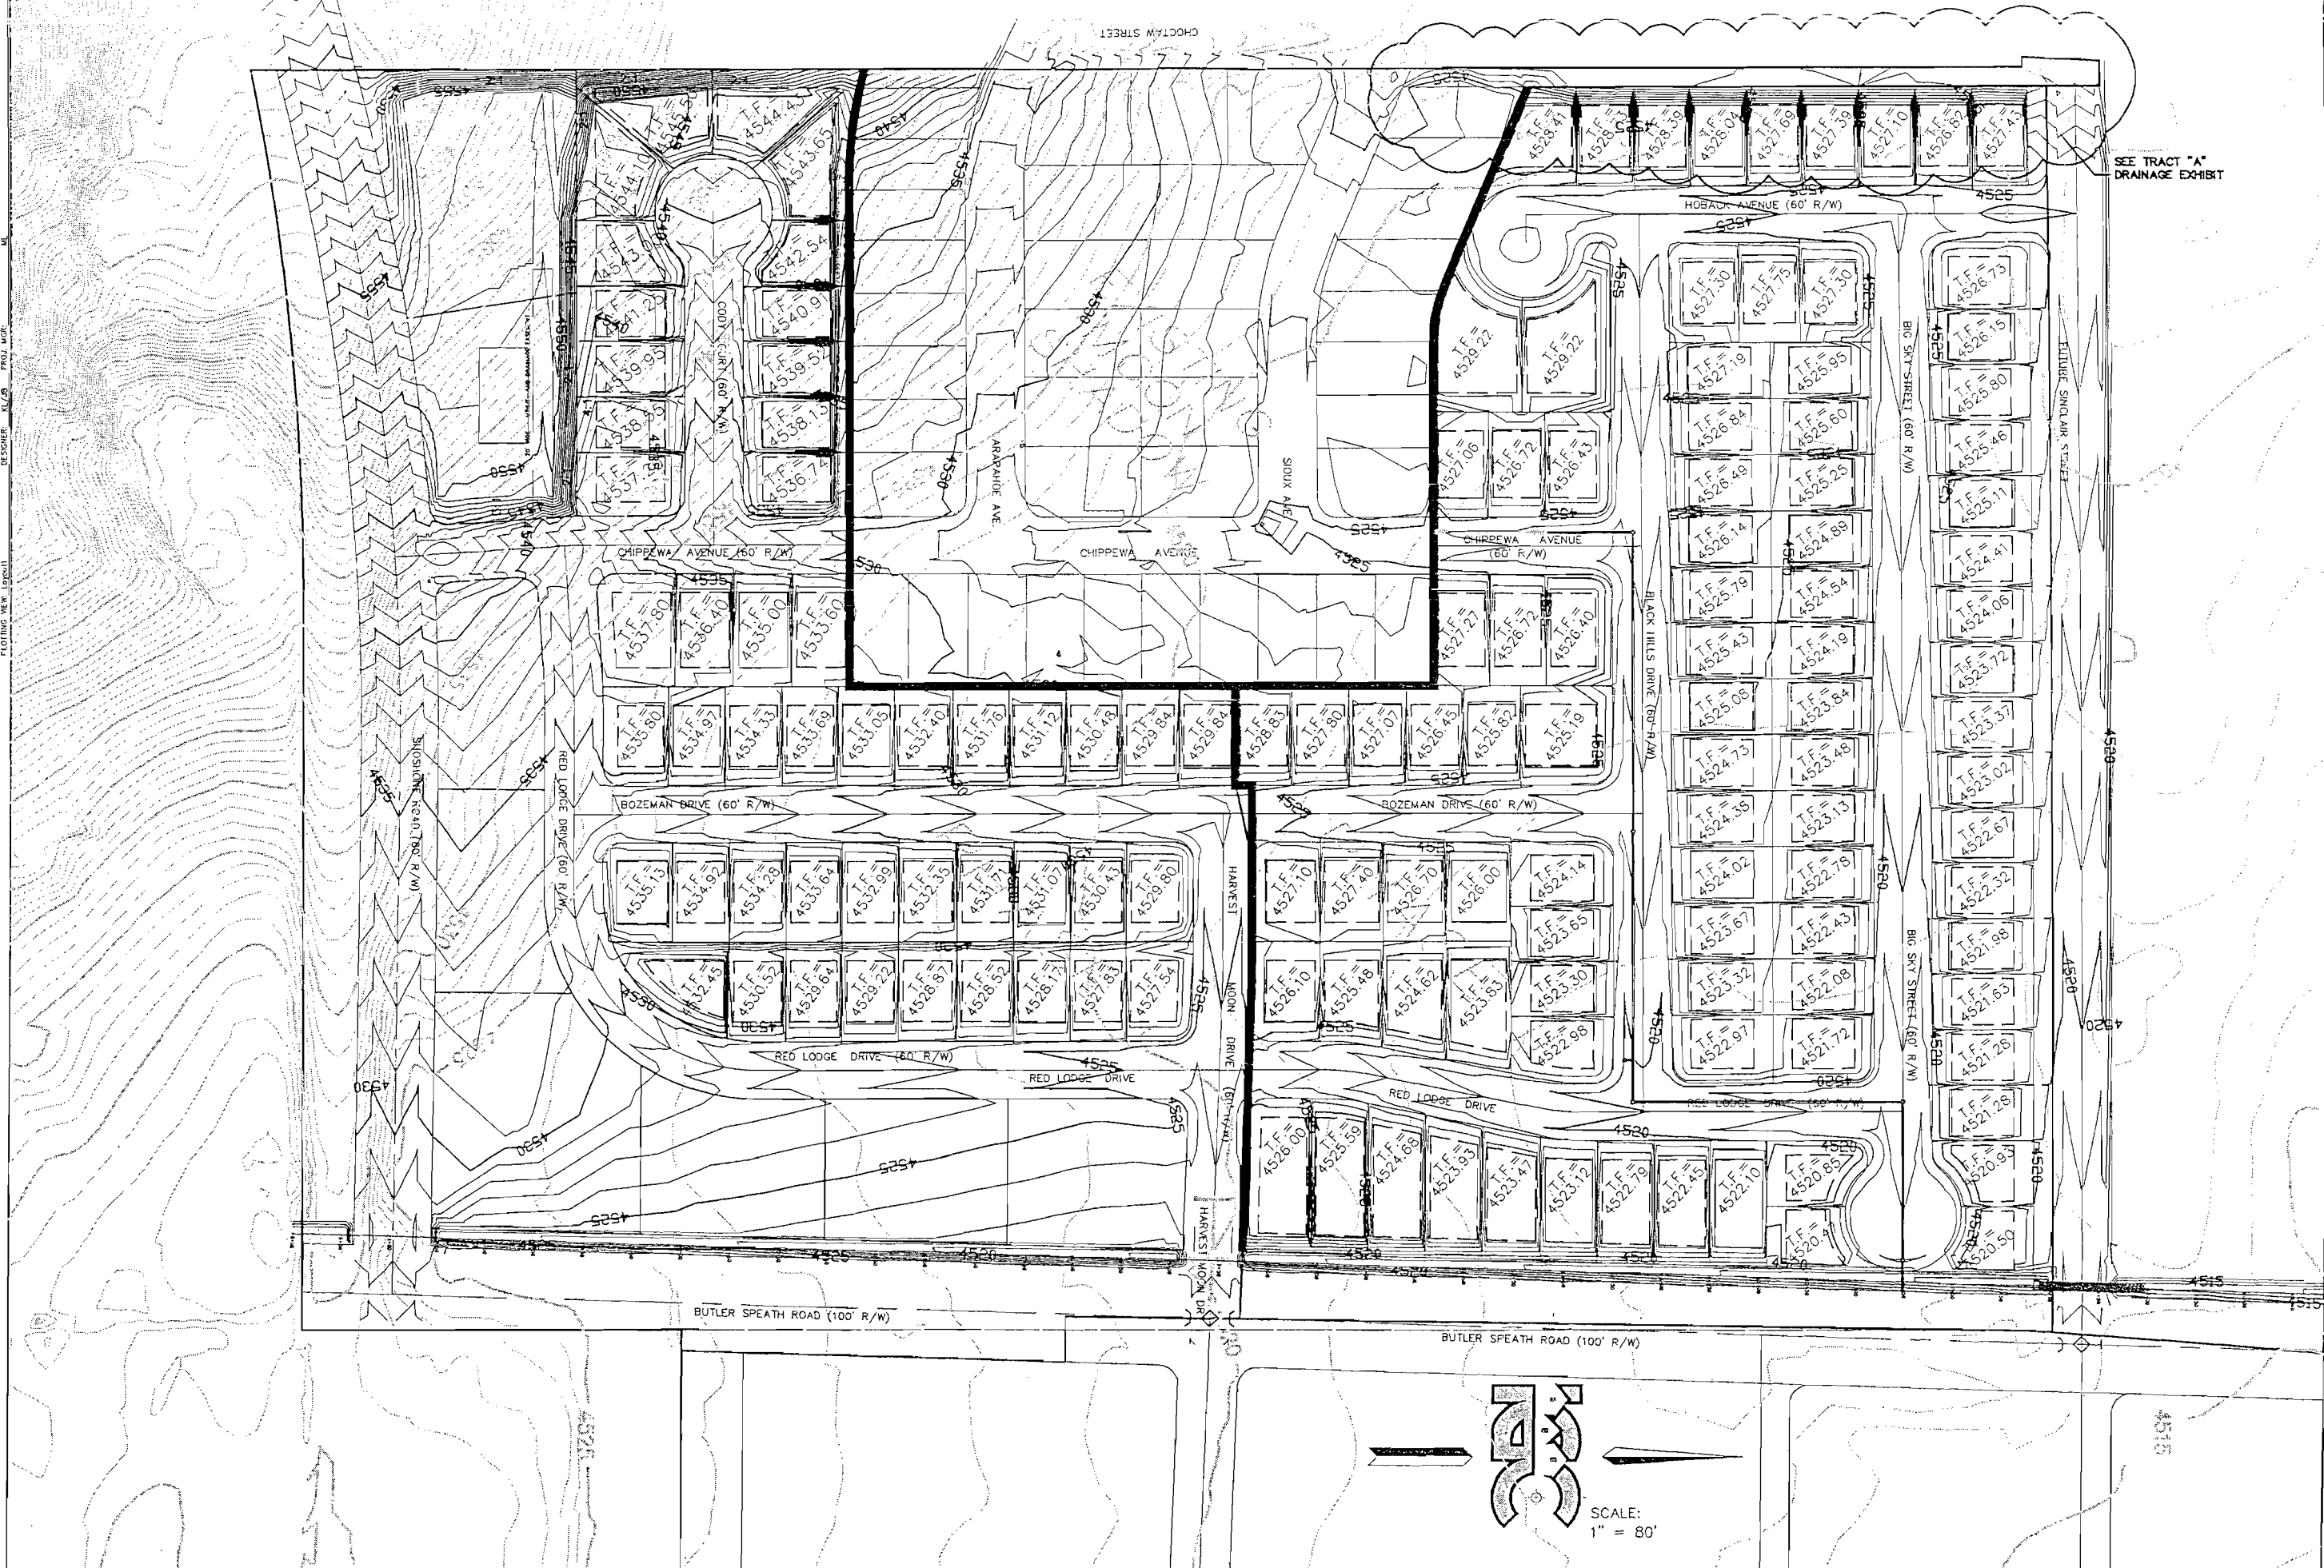


SEE TRACT "A" DRAINAGE EXHIBIT

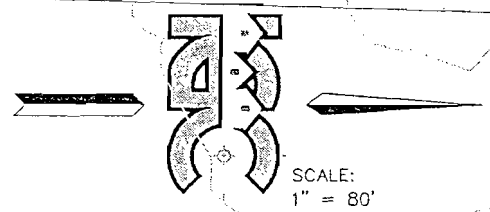

# MOON SHADOW FILING 2 FINISH GRADING PLAN

IGC MANAGEMENT INC.  
 1807 Capitol Avenue  
 Cheyenne, WY 82001  
 Office: 307.635.5773  
 Fax: 307.635.7227

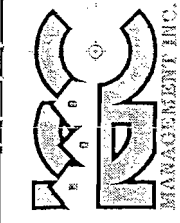

SHEET NUMBER: FG1  
 OF 1 SHEETS  
 SCALE: 1"=80'  
 VERTICAL: 1"=80'  
 HORIZONTAL: 1"=80'  
 JOB NUMBER: G105-0005

CLIENT: GILLETTE LAND DEVELOPMENT DATE SUBMITTED: 10-27-2006

NO.	DATE	BY	REVISIONS (DESCR.)
1	10-27-06	GWB	ISSUED TO PLAN PER CITY A.L. COMMENTS PER CITY OF GILLETTE
2	12-09-06	KI	INTERIM RECORD DRAWINGS
3	07-31-07	GWB	FINAL RECORD DRAWINGS
4			

NOTES:  
 The engineer preparing these plans will not be responsible for the accuracy of the information shown on these plans. All changes to the plans must be in writing and must be approved by the preparer of these plans.