
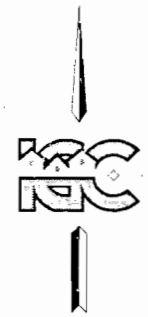
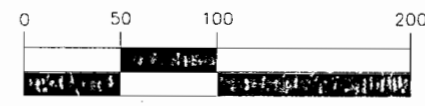


REF: 0100A
 REF: 0100B
 REF: 0100C
 REF: 0100D


PLOT DATE/TIME: Nov 30, 2006 - 1:58pm DRAWING PATH: C:\WORKSPACE\GILLETTE\0505-0003\MOON MEADOW
 PLOTTED BY: JMF DRAWING NAME: CP-REC'DWG-FG 04
 PLOTTING VIEW: REC DESIGNED BY: KJ PROJ: MGR VI

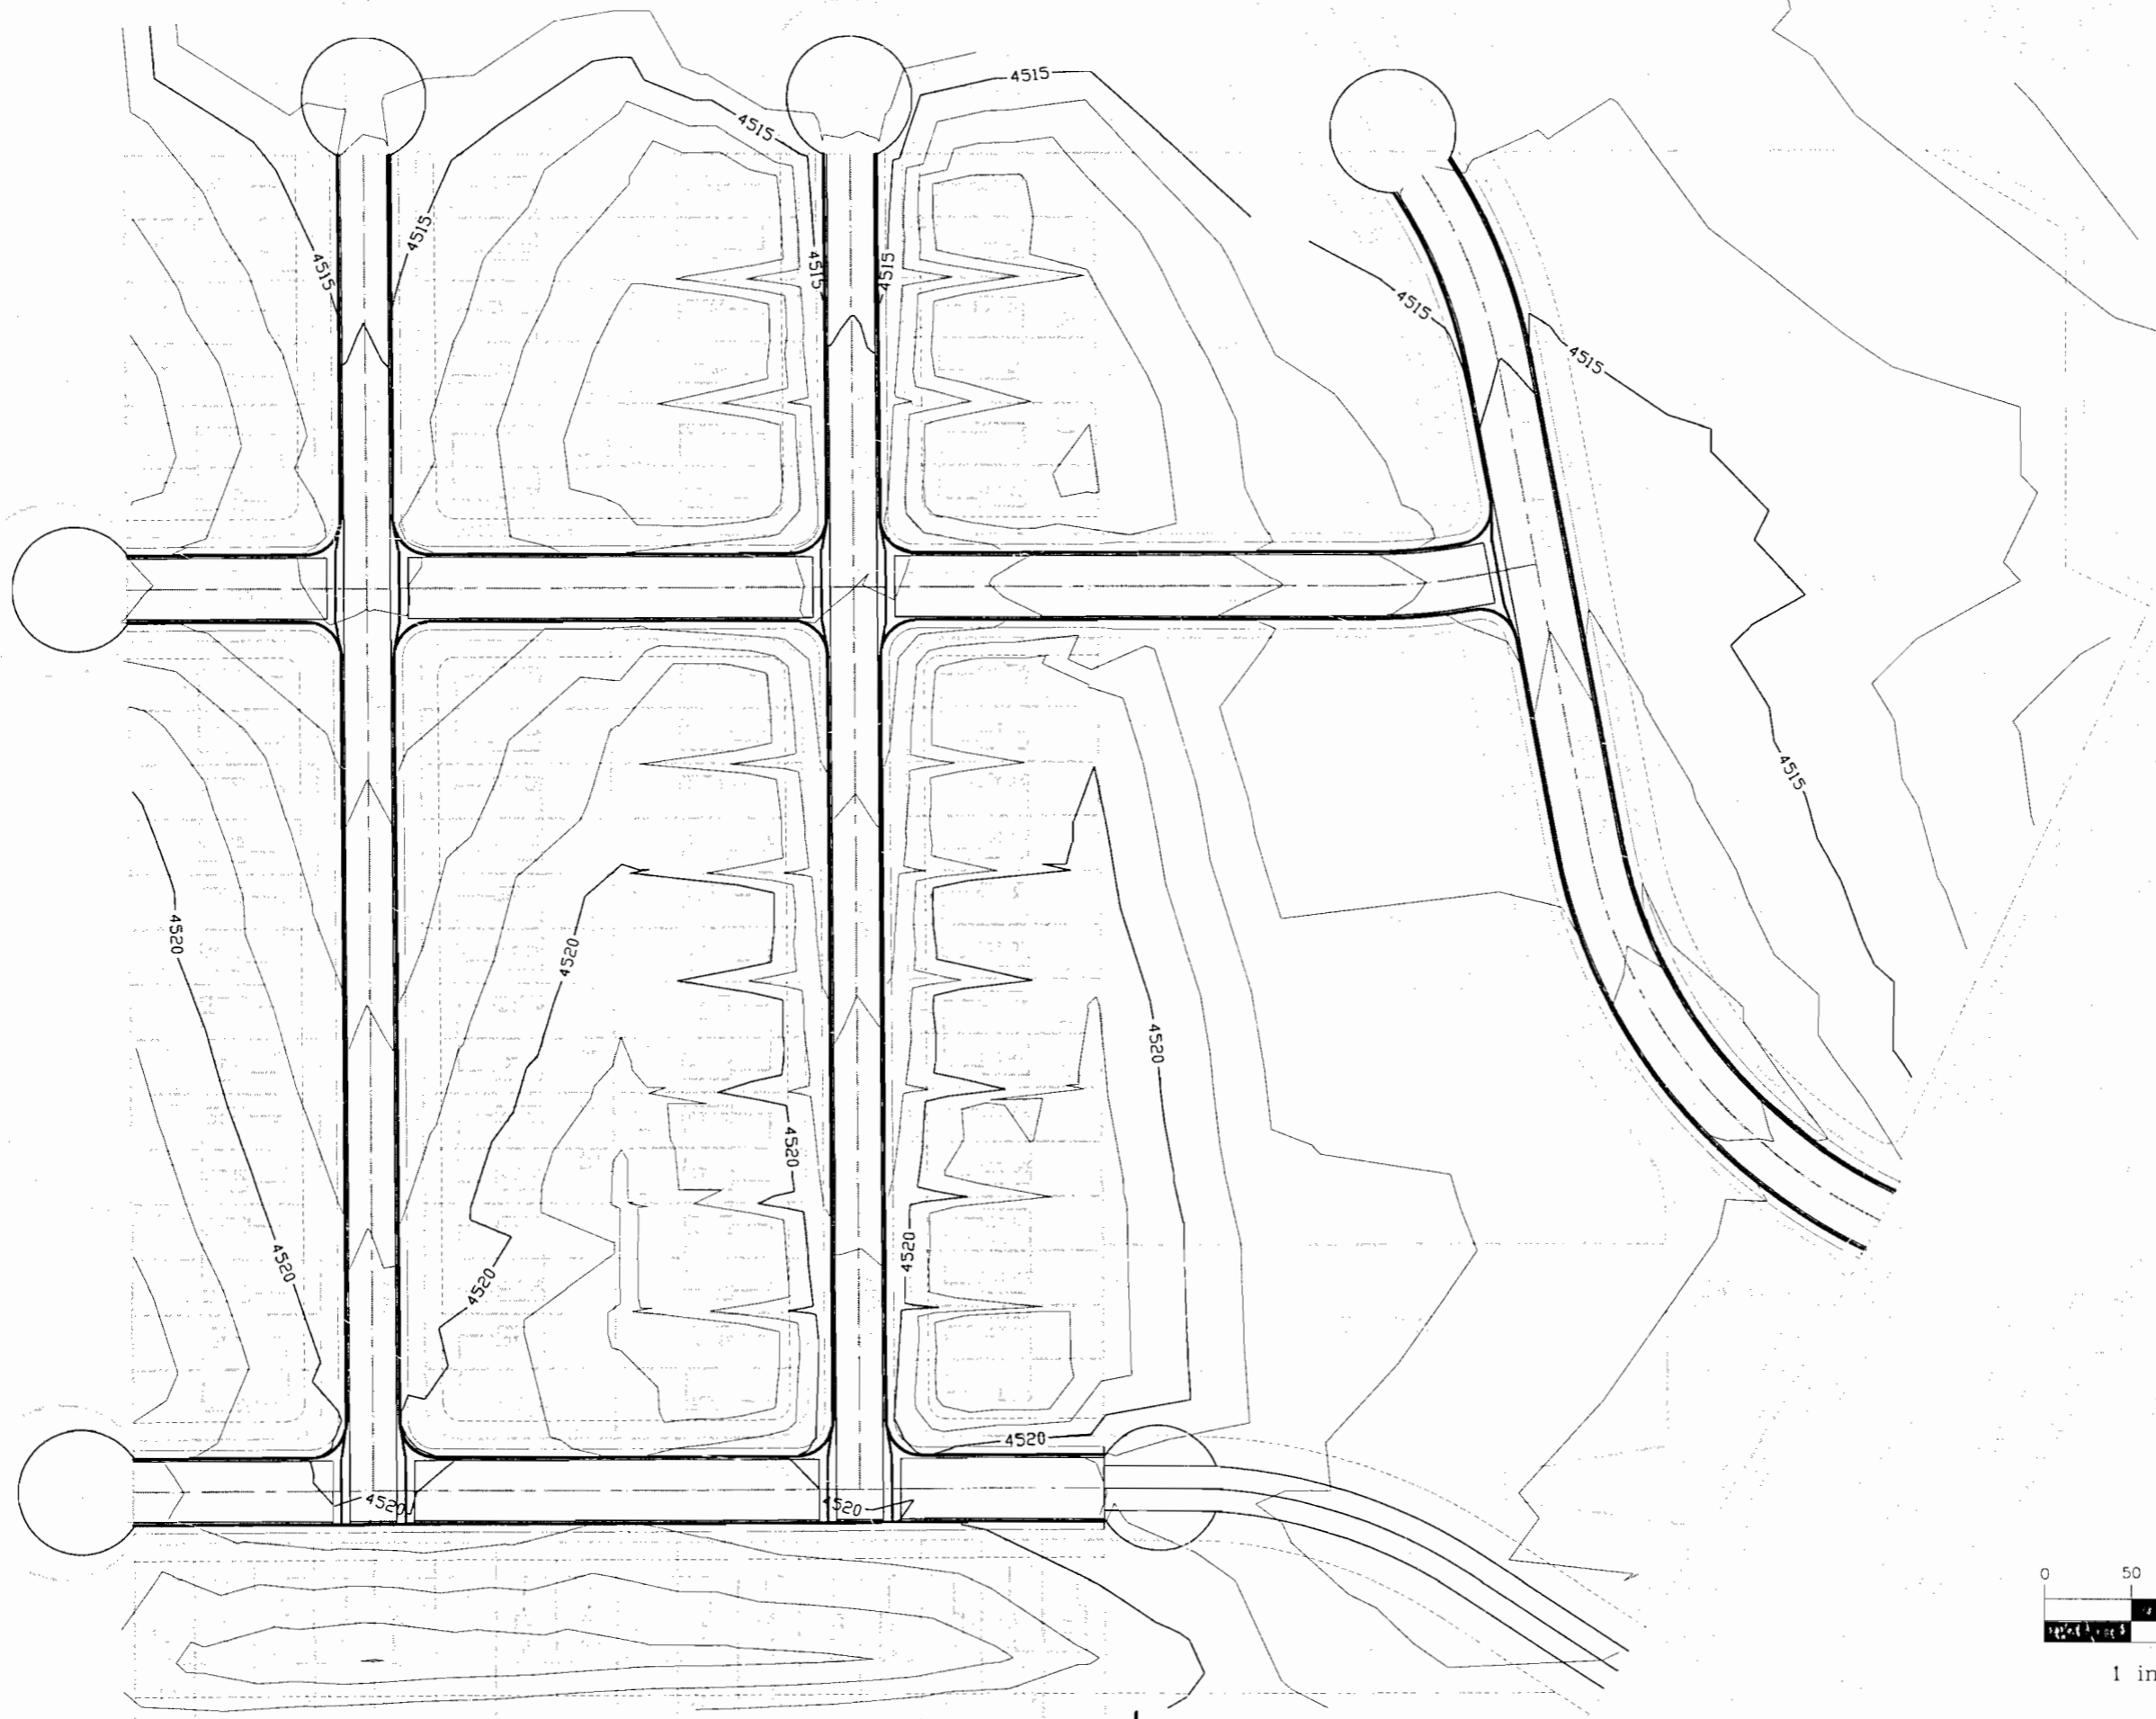

SHEET NUMBER
REC-FG1
 OF 1 SHEETS

SCALE
 VERTICAL: N/A
 HORIZONTAL: 1"=100'

JOB NUMBER
G105-0003

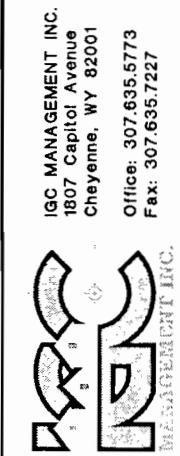

IGC MANAGEMENT INC.
 1807 Capitol Avenue
 Cheyenne, WY 82001
 Office: 307.635.5773
 Fax: 307.635.7227

MOON MEADOW SUBDIVISION
AS-BUILT FINISH GRADE
CONTOURS

CLIENT: GILLETTE LAND DEVELOPMENT II, INC. DATE SUBMITTED: 12-12-2005

NO.	DATE	BY	KL	DESCRIPTION
1	11-27-06			FINAL RECORD DRAWINGS

The engineer hereby certifies that the plans and specifications are true and correct to the best of his knowledge and belief, and that he is not providing any false or misleading information. These plans, specifications, and drawings are the property of the engineer and must be returned to the engineer at the time of final payment.