


TYPICAL "A" LOT
NOT TO SCALE

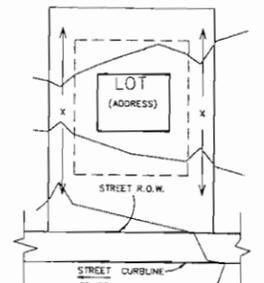



TYPICAL "B" LOT
NOT TO SCALE

* DRAINAGE PATTERNS FOR "A" LOTS MUST ALSO ACCEPT RUNOFF FROM REAR YARD OF ADJACENT UP-HILL LOTS IF APPLICABLE.


CONTOUR EXAMPLES SHOWN PER CITY OF GILLETTE REQUEST

TYPICAL "T" LOT
TRANSITION LOTS - NOT TYPICAL BY TEMPLATE

INTERIM RECORD DRAWINGS

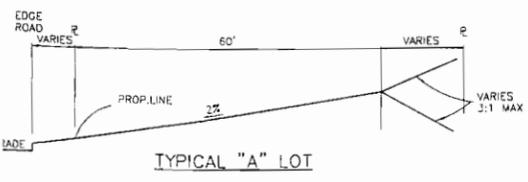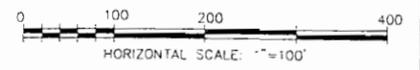

TYPICAL "A" LOT

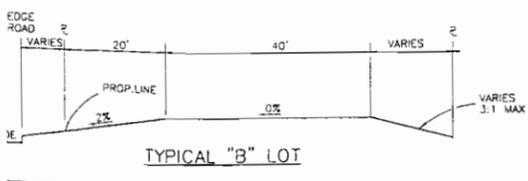

TYPICAL "B" LOT

TOF: REPRESENTS A RECOMMENDED TOP OF FOUNDATION ELEVATION TO PRODUCE PREFERRED DRAINAGE ON THE LOT BASED ON A 40'X40' FOOTPRINT HOME. FINAL FOUNDATION ELEVATIONS ARE THE RESPONSIBILITY OF THE HOME BUILDER. VERIFY GRADING AROUND THE HOME IS COMPLETED AND POSITIVE DRAINAGE AT 2% MINIMUM IS MAINTAINED.

**GRADING PLAN - PHASE 1
IRON HORSE SUBDIVISION - PHASE 1
MRJ DEVELOPMENT
GILLETTE, WYOMING**



ARCHITECTS • ENGINEERS • SURVEYORS
237 North Main St. - Sheridan, WY 82801 - (307) 672-1711
400 South Miller Ave. - Gillette, WY 82715 - (307) 682-1141

DATE: 03/22/07
DRWN BY: jes

PROJECT NO.
506048

SCALE: (H) 1" = 100'

SHEET NO.