
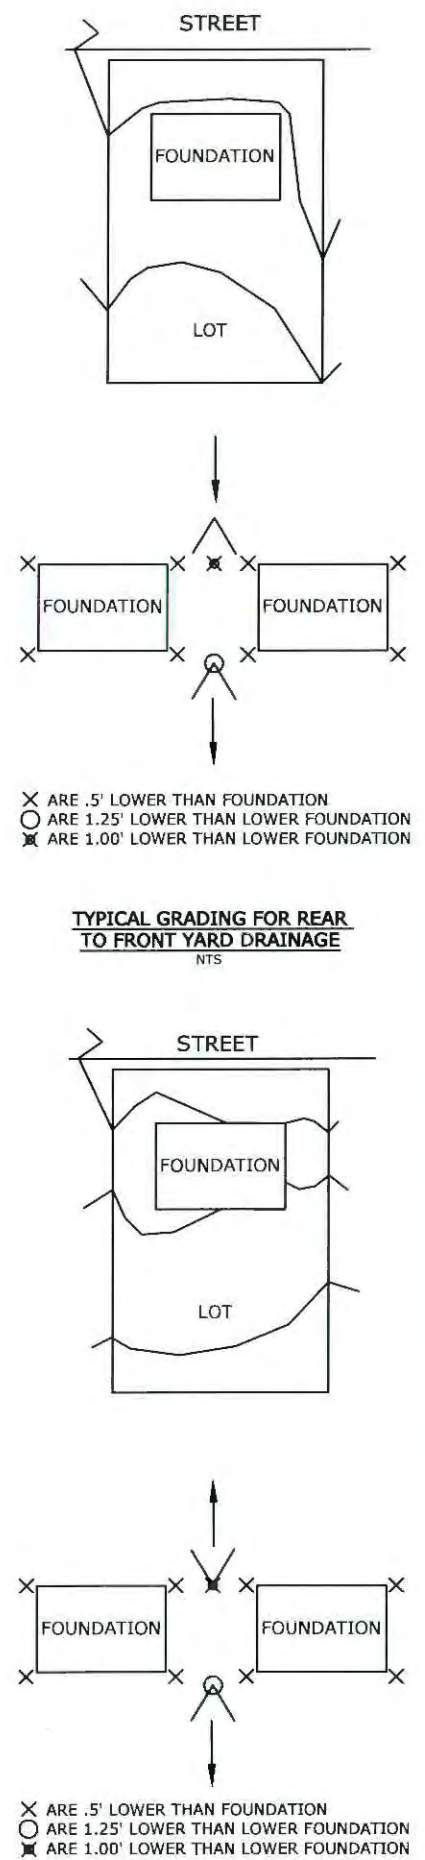
 LOTS WITH REAR YARD DRAINAGE
     
  LOTS WITH FRONT YARD DRAINAGE



"RECORD DRAWING"



REV.	DATE	BY	DESCRIPTION
1	11/11	DJP	RECORD DRAWING

# REMINGTON ESTATES SUBD. PHASE III, FILING 2 OVERLOT GRADING PLAN

**DOYLE LAND SURVEYING**  
 This drawing and all parts thereof is the exclusive property of Doyle Land Surveying, 801 E 4th Street Suite 15, Gillette, Wyoming and may not be reproduced in whole or part without written permission.

DATE: 11/11/2011  
 JOB NO.: 111111  
 DRAWN BY: DJP  
 APPROVED BY: DJP