

--- EXISTING CONTOURS
 ——— DESIGN CONTOURS

**WESTERN SKY SUBDIVISION
 PHASE IV, FILING 1
 DETAILED GRADING PLAN**





REV. #	REVISION DESCRIPTION	DATE	BY

DOYLE LAND SURVEYING
 This drawing and all parts thereof is the exclusive property of Doyle Land Surveying, 801 E 4th Street Suite 15, Gillette, Wyoming and may not be reproduced in whole or part without written permission.

DATE: 04/18/2012
 JOB NO: XXXXXXXX
 DRAWN BY: DJS
 APPROVED BY: CJB

DETAILED GRADING PLAN
 DG-1

"RECORD DRAWING"

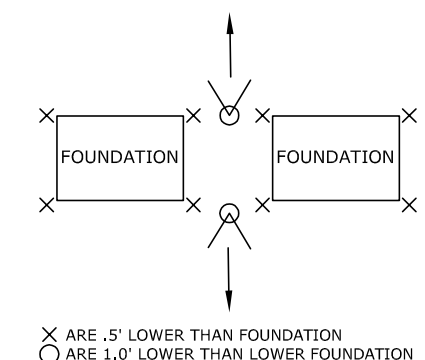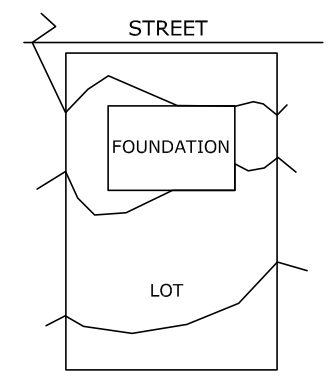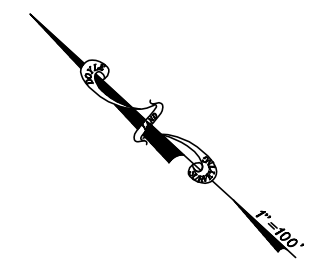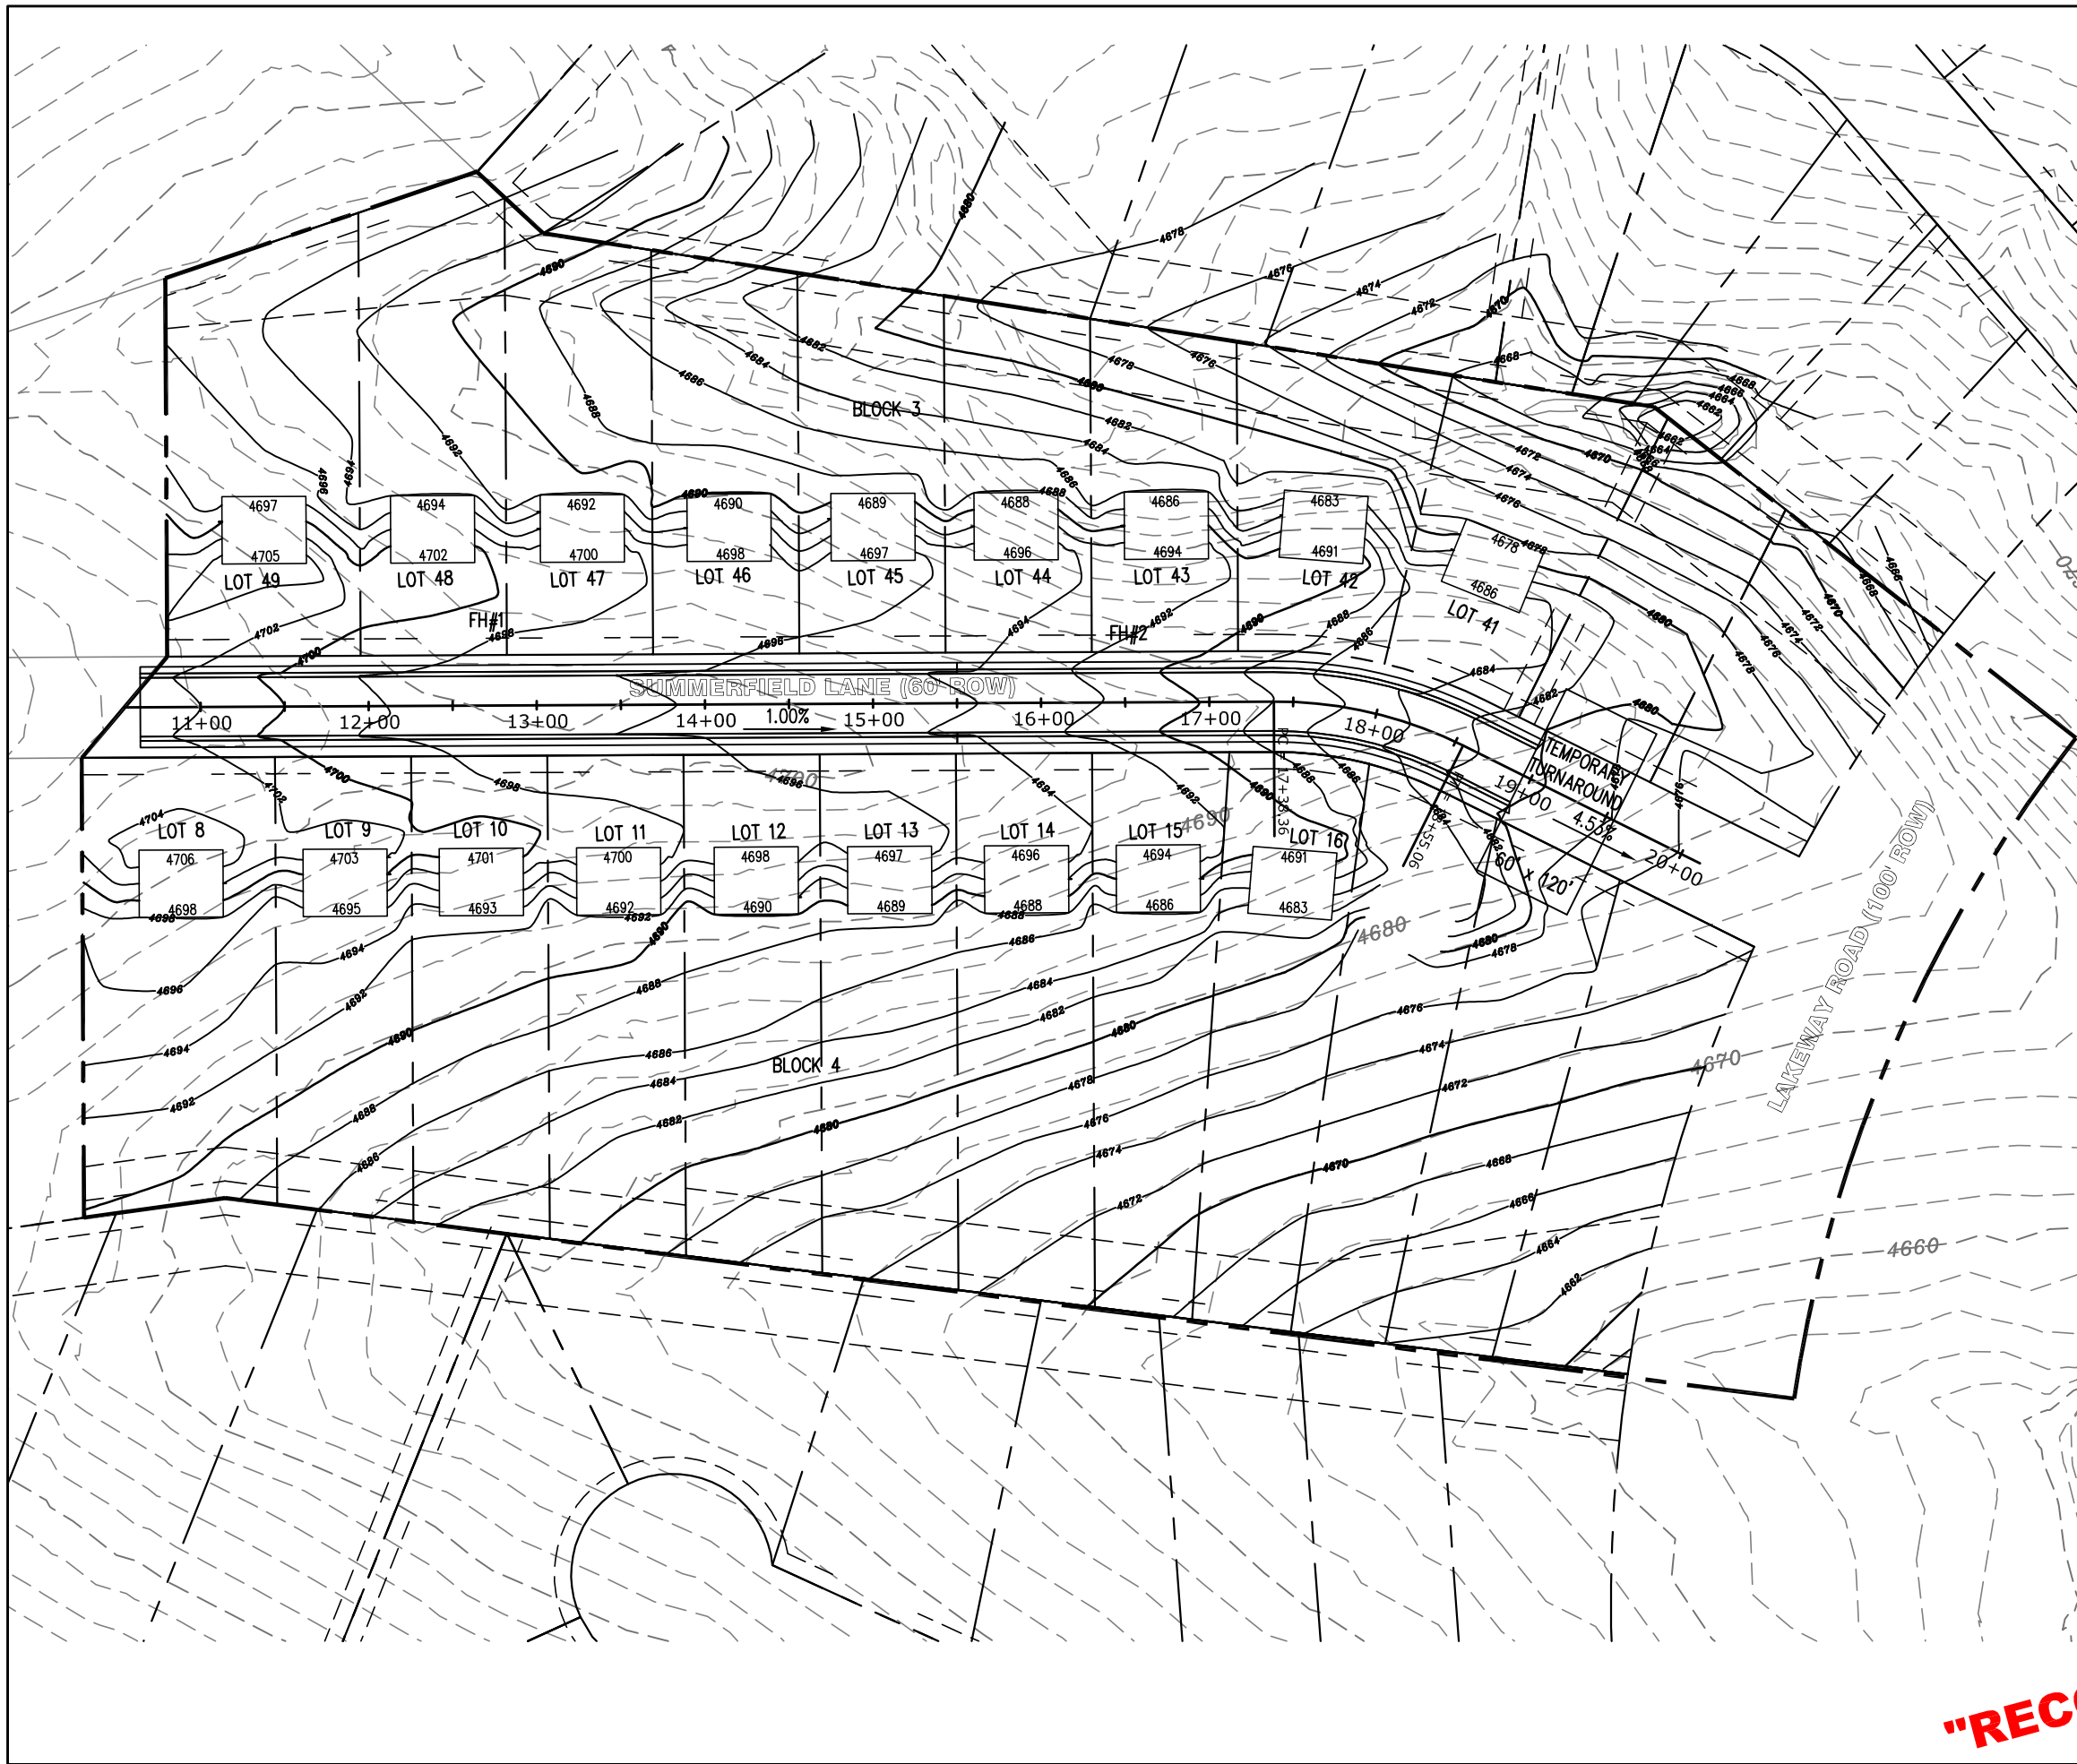

TYPICAL GRADING FOR DRAINAGE TO REAR YARD
NTS

REV. #	REVISION DESCRIPTION	DATE	BY

**WESTERN SKY SUBDIVISION
PHASE IV, FILING 1
OVERLOT GRADING PLAN**

DOYLE LAND SURVEYING
This drawing and all parts thereof is the exclusive property of Doyle Land Surveying, 801 E 4th Street Suite 15, Gillette, Wyoming and may not be reproduced in whole or part without written permission.

DATE: 04/18/2012
JOB NO: XXXXXXXX
DRAWN BY: DJS
APPROVED BY: CJB

"RECORD DRAWING"